

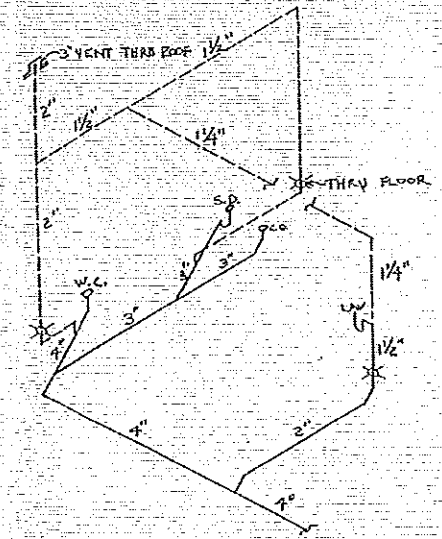


PLUMBING PLAN - BUILDING 'B'

SCALE 1/4" = 1'-0"
 ~ 1/8" = 1'-0"

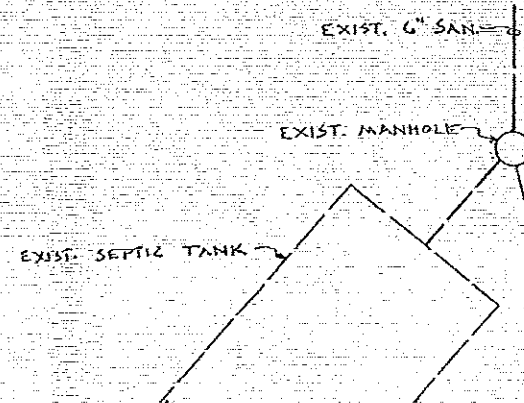

STACK NO. 4 DIAGRAM
 STACK NO. 6 - OPPOSITE HAND

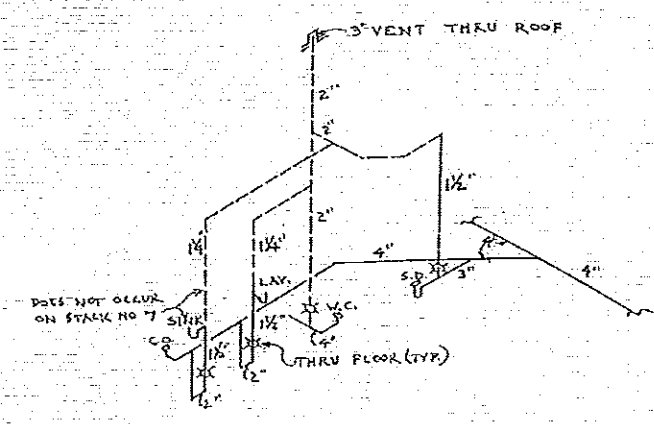

STACK NO. 5 DIAGRAM
 STACK NO. 7 - OPPOSITE HAND

